


FORTIS BC GAS
 GAS SERVICE INSTALLATION
 45608 STEVENSON RD




7 Feb 18 03:41p

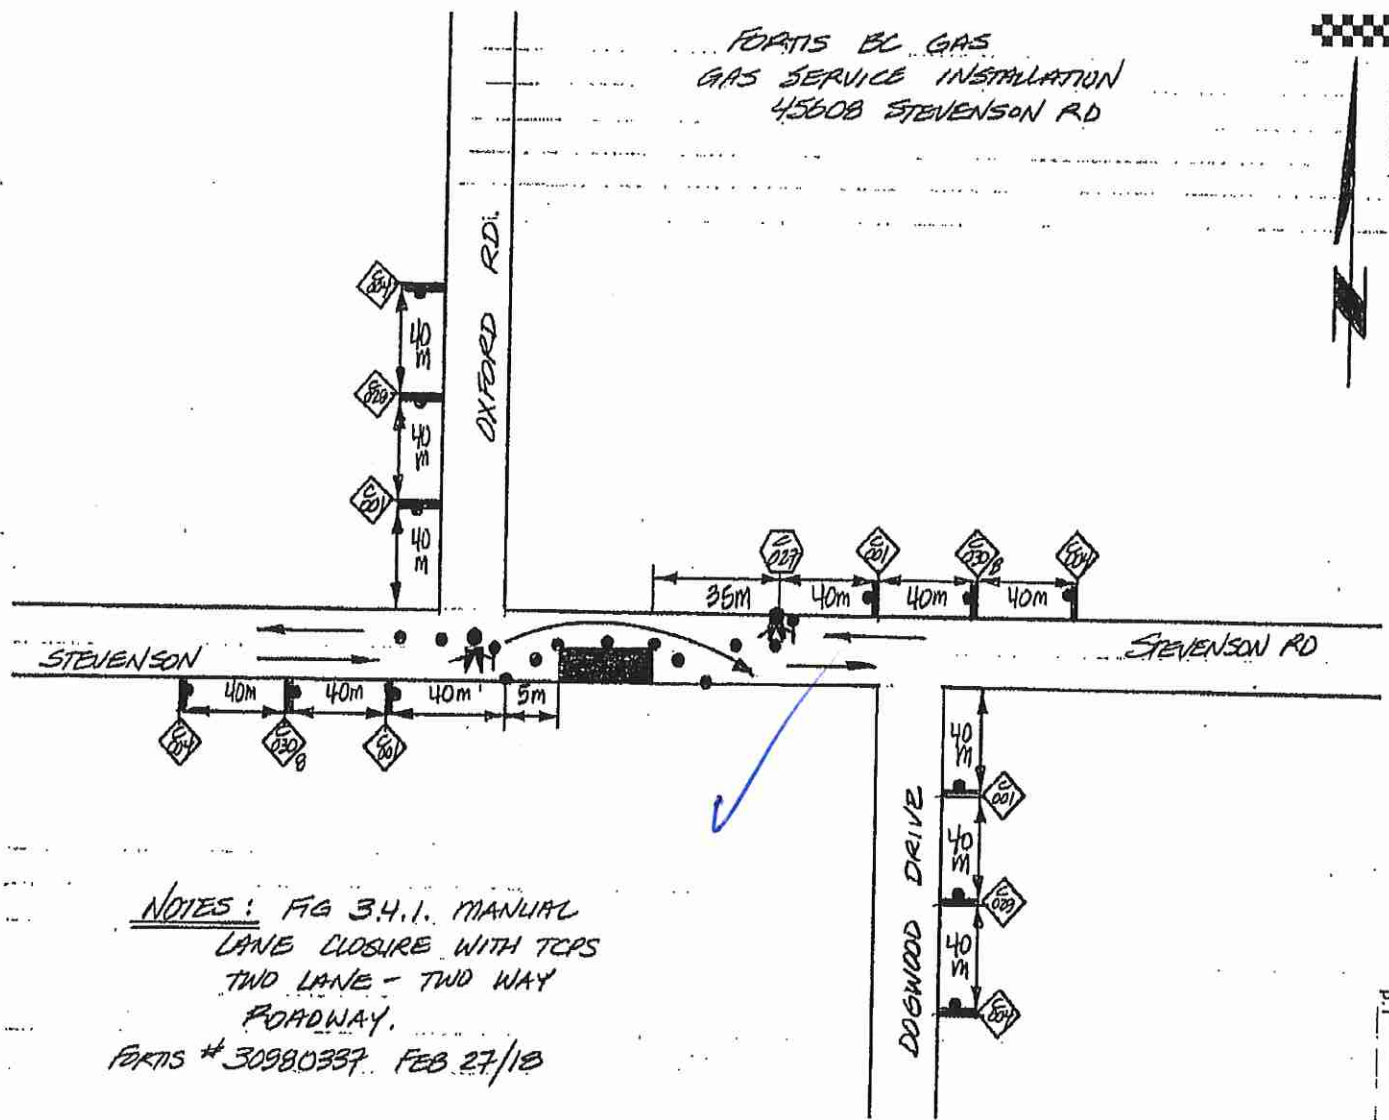

NOTES: FIG 3.4.1. MANUAL
 LANE CLOSURE WITH TCPS
 TWO LANE - TWO WAY
 ROADWAY.
 FORTIS # 30980337 FEB 27/18

4110289884

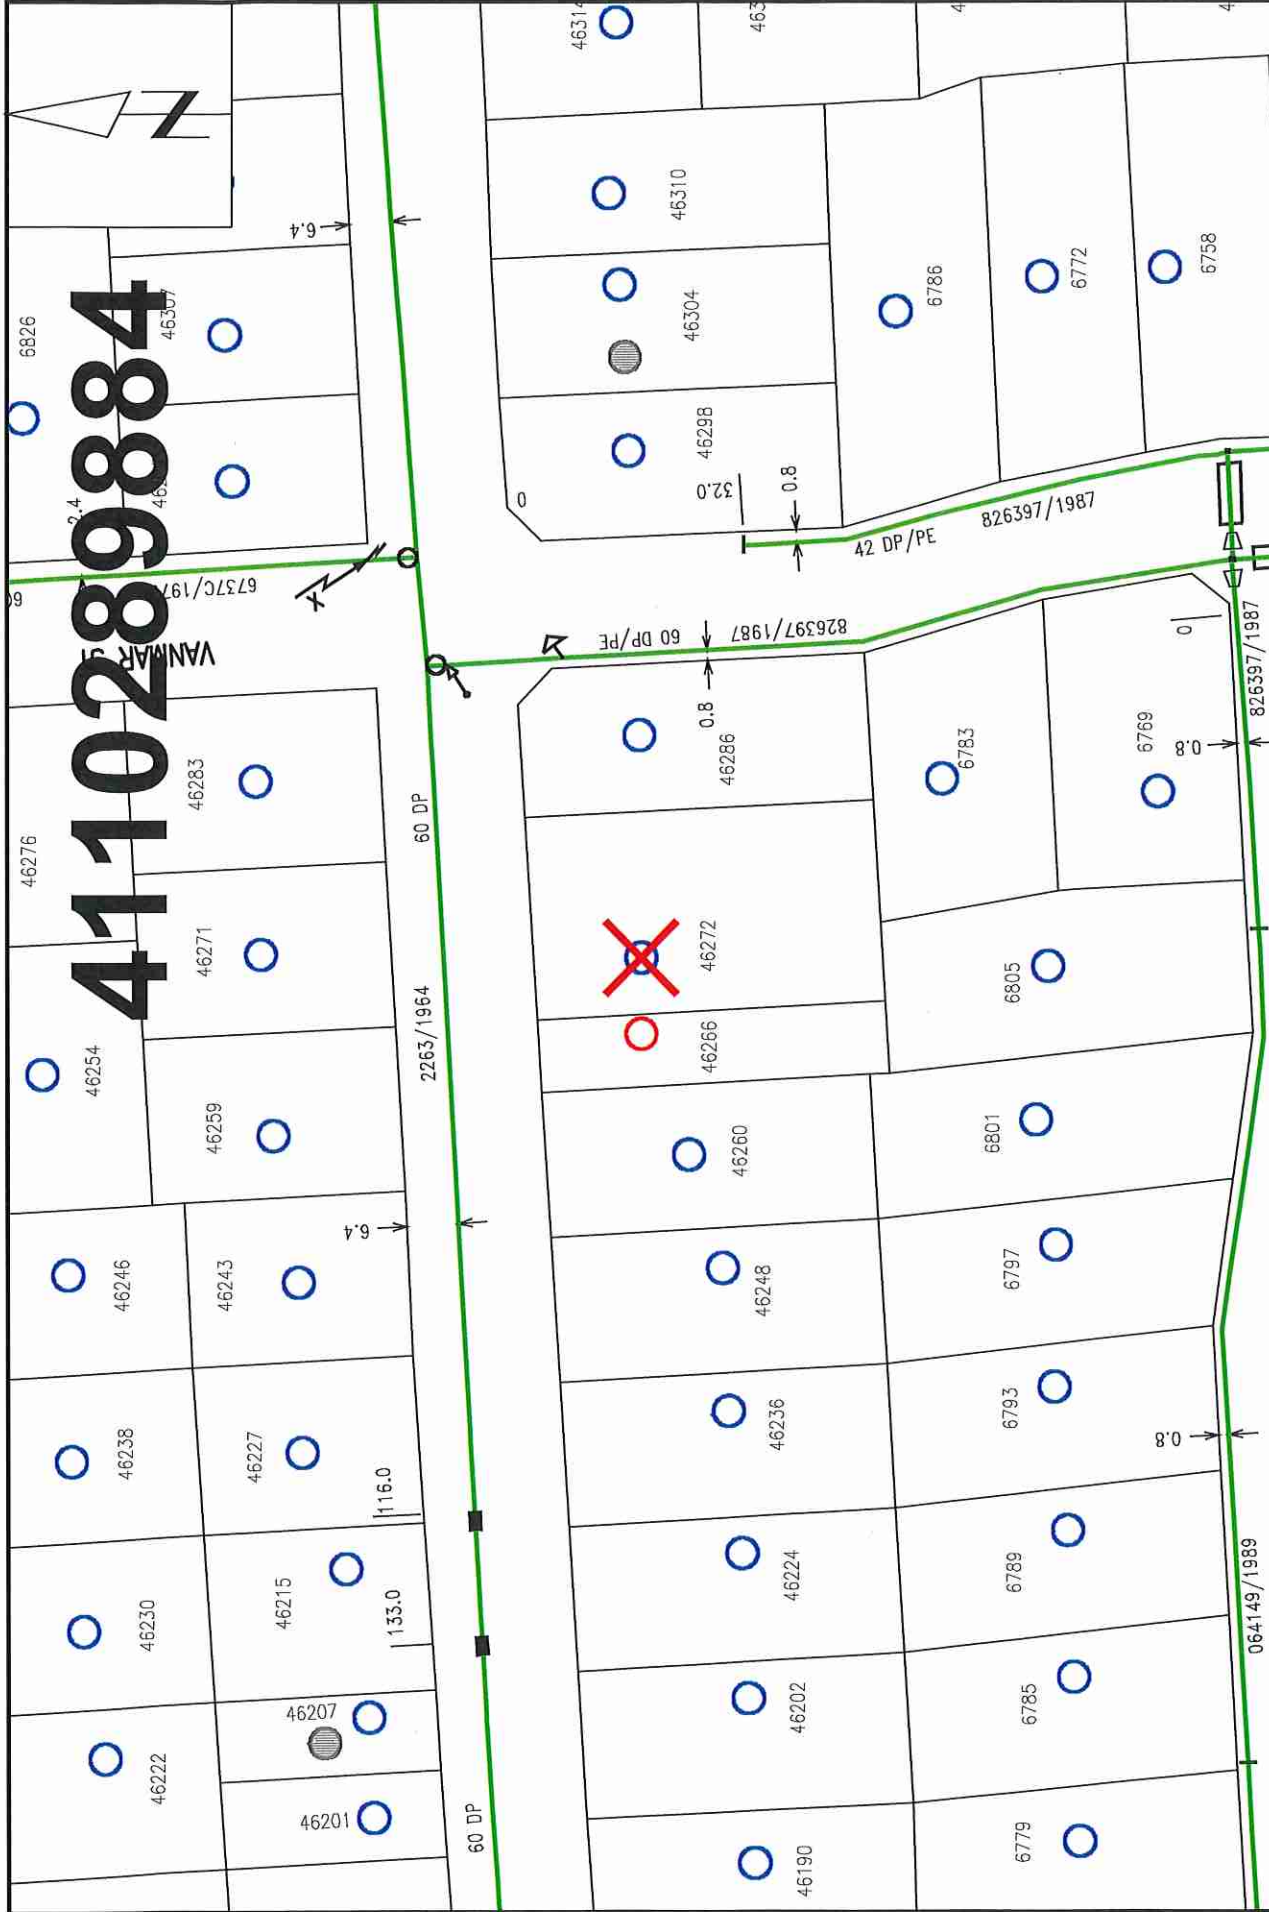

46272 Stevenson Rd, Chilliwack

Nearest Intersection: Stevenson Rd and Vanmar St.
Distance from lot to intersection is 52 meters (29 degrees North of East).
View Scale: 1:1000

Order #: 30981458 Prem #: 256140 City Limits: Chilliwack


X: 1296177819.00 Y: 465065776.00

Select autotext type 2018/01/29

ATTENTION: DO NOT RELY ON THIS INFORMATION ALONE. You must manually dig to locate gas lines before using excavation machinery. All locations are shown approximate only & gas lines built after the date below are not in this information package. FortisBC will not accept responsibility for errors or omissions. Depth of gas line are not available due to possible change of grade.

UNIT # 2 HOUSE # 46272 ST. DIR. Higginson ST. NAME Higginson Rd. SUFFIX CHK MINCP. CHK TRANS TRUNK
 ADDRESS SERVED 46272 Higginson Rd. CHK HIGH MED. LOW
 MAIN SERVED FROM SIZE 2" OFFSET 6.4 m FROM N SIDE OF HIGGINSON Rd MAT. ST. CI PL PE
 DEPTH 1.2 m
 SERVICE SIZE 1/2" LOC 5.3 m DIR W FROM N.E. COR. OF E.P.L. METHOD OF TIE H.P.S.C. MAT. ST. PL PE
 TAP SIZE 5/16
 CURB COCK NO YES LOC. CASR NO YES LOC. MA. SIZE BELGR. ENTRY INSIDE METER

SERVICE PIPE
 LENGTH 13.7 SIZE 1/2
 MANPL. 19.2
 PL/BLDG.
 JOG
 VERT. EXT. PAST COR. 1.6
 RISER TOTAL RUN 33.9 SIZE 1/2
 SCRAP
 INSULATED AT MAIN PL
 TEST & TRANS.
 RENEWAL PART COMP
 NOT TAPPED
 PRERUN TAPPED WAIR
 OLD SERVICE CUTOFF YES NO
 AT MAIN OTHER
 OLD PIPE REMOVED INL US
 PIPE ABAN. LGTH. SIZE
 METERS REMOVED
 READING

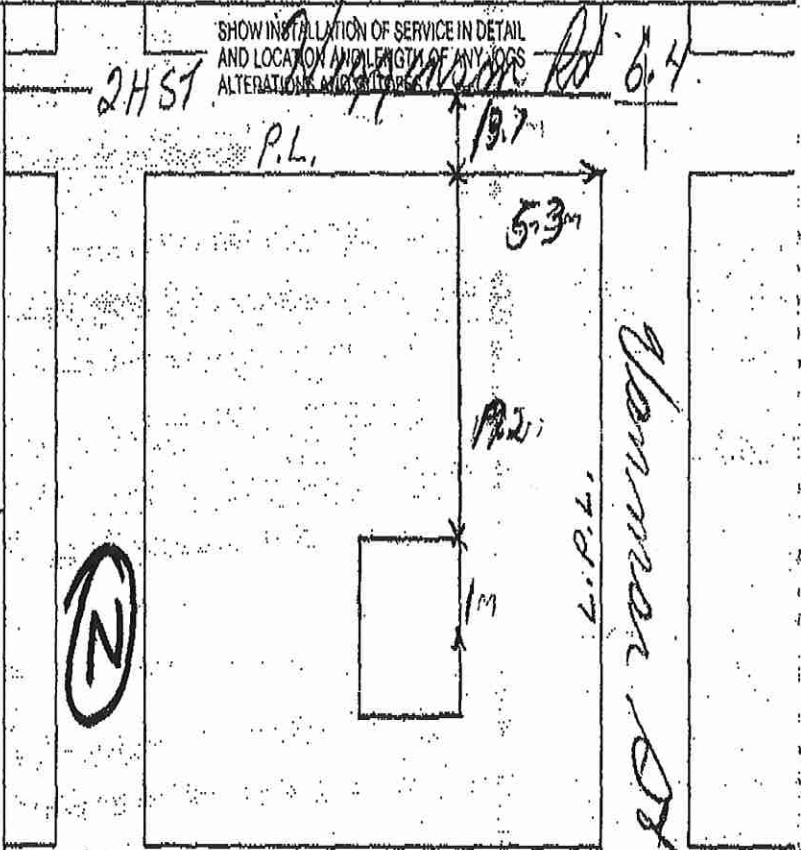

COSTING

UGHL MA. SIZE SLATER
 CASING POSTS
 PAVEMENT: SAVED-SIDEWALK PAVEMENT
 PAVE. CUT TRENCH RUN CUT BELL HOLE
 NO. OF CUTS AVG. THICKNESS CALLED IN YES NO
 METER NO. INSTALLED RAT. 84668
 READING 4186

INSPECTION REPORT: I HEREBY CERTIFY THAT THE PIPING WAS INSTALLED IN ACCORDANCE WITH AUTHORITY STANDARD PRACTICES AND WAS EXAMINED UNDER AN AIR TEST OF 670 kPa FOR 10 MINS. AND THAT NO LEAKAGE WAS INSTALLED.
 FOREMAN W. [Signature] DATE 90/03/29
 FURTHER WORK REQD: YES NO WORK COMPLETED BY CONTRACTOR

NOTICE TO CONTRACTORS: B.C. HYDRO & POWER AUTHORITY DOES NOT ACCEPT ANY RESPONSIBILITY FOR ERRORS OR OMISSIONS IN THE LOCATIONS SHOWN FOR EXISTING UNDERGROUND UTILITIES AND STRUCTURES. ALL SUCH LOCATIONS SHOWN ARE APPROXIMATE ONLY AND MUST BE CONFIRMED BY THE USE OF PIPE LOCATOR AND MANUAL DIGGING.

PROV. HWY DEPTH CHECKED BY SPVTR. m COVER
 SUPERVISOR [Signature]

P.E. INFO. COUL. 182 89/10/27 DRISED PIPE